

**NEUROSCIENCE**  
**2023**

---

Halls A, B, C, E, L Street Bridge and the SfN Booth

---

As of November 2, 2023

Society for Neuroscience  
November 11-15 (Meeting) November 12-15 (Exhibits)

**EXHIBIT HALLS A,B,C**

WALTER E. WASHINGTON CONVENTION CENTER  
WASHINGTON, D.C.

WCC - Please add rounds and chairs in the areas marked seating area - highlighted yellow.



Inventory as of 10/01/2023

Dimension	Size	Qty	SqFt
10'x10'	100	381	38,100
10'x20'	200	90	18,000
10'x30'	300	12	3,600
20'x20'	400	19	7,600
10'x50'	500	2	1,000
10'x60'	600	2	1,200
20'x30'	600	7	4,200
20'x40'	800	2	1,600
30'x30'	900	3	2,700
20'x50'	1,000	1	1,000
30'x40'	1,200	1	1,200
30'x50'	1,500	1	1,500
40'x40'	1,600	1	1,600
40'x50'	2,000	2	4,000
50'x50'	2,500	1	2,500
<b>Totals:</b>	<b>525</b>	<b>89,800</b>	

POSTERBOARDS  
SS - 4X6.....120  
DS - 4X6.....610  
1,340 POSTER BOARD FACES

9TH ST., ABOVE


- Current As Of: 10-01-2023
- Job No.: 2311006
- Drawn By: sa
- Scale: Fit To Page

**THE EXPO GROUP**  
theexpogroup.com | 972.580.9000

\*This floor plan is subject to fire marshal approval.

**Disclaimer**  
Every effort has been made to ensure the accuracy of all information contained on this floor plan. However no warranties, either expressed or implied are made with respect to this floor plan. If the location of building columns, utilities or other architectural components of the facility is a consideration in the construction or usage of an exhibit, it is the sole responsibility of the exhibitor to physically inspect the facility to verify all dimensions and locations.

E = Electrical  
I = Internet

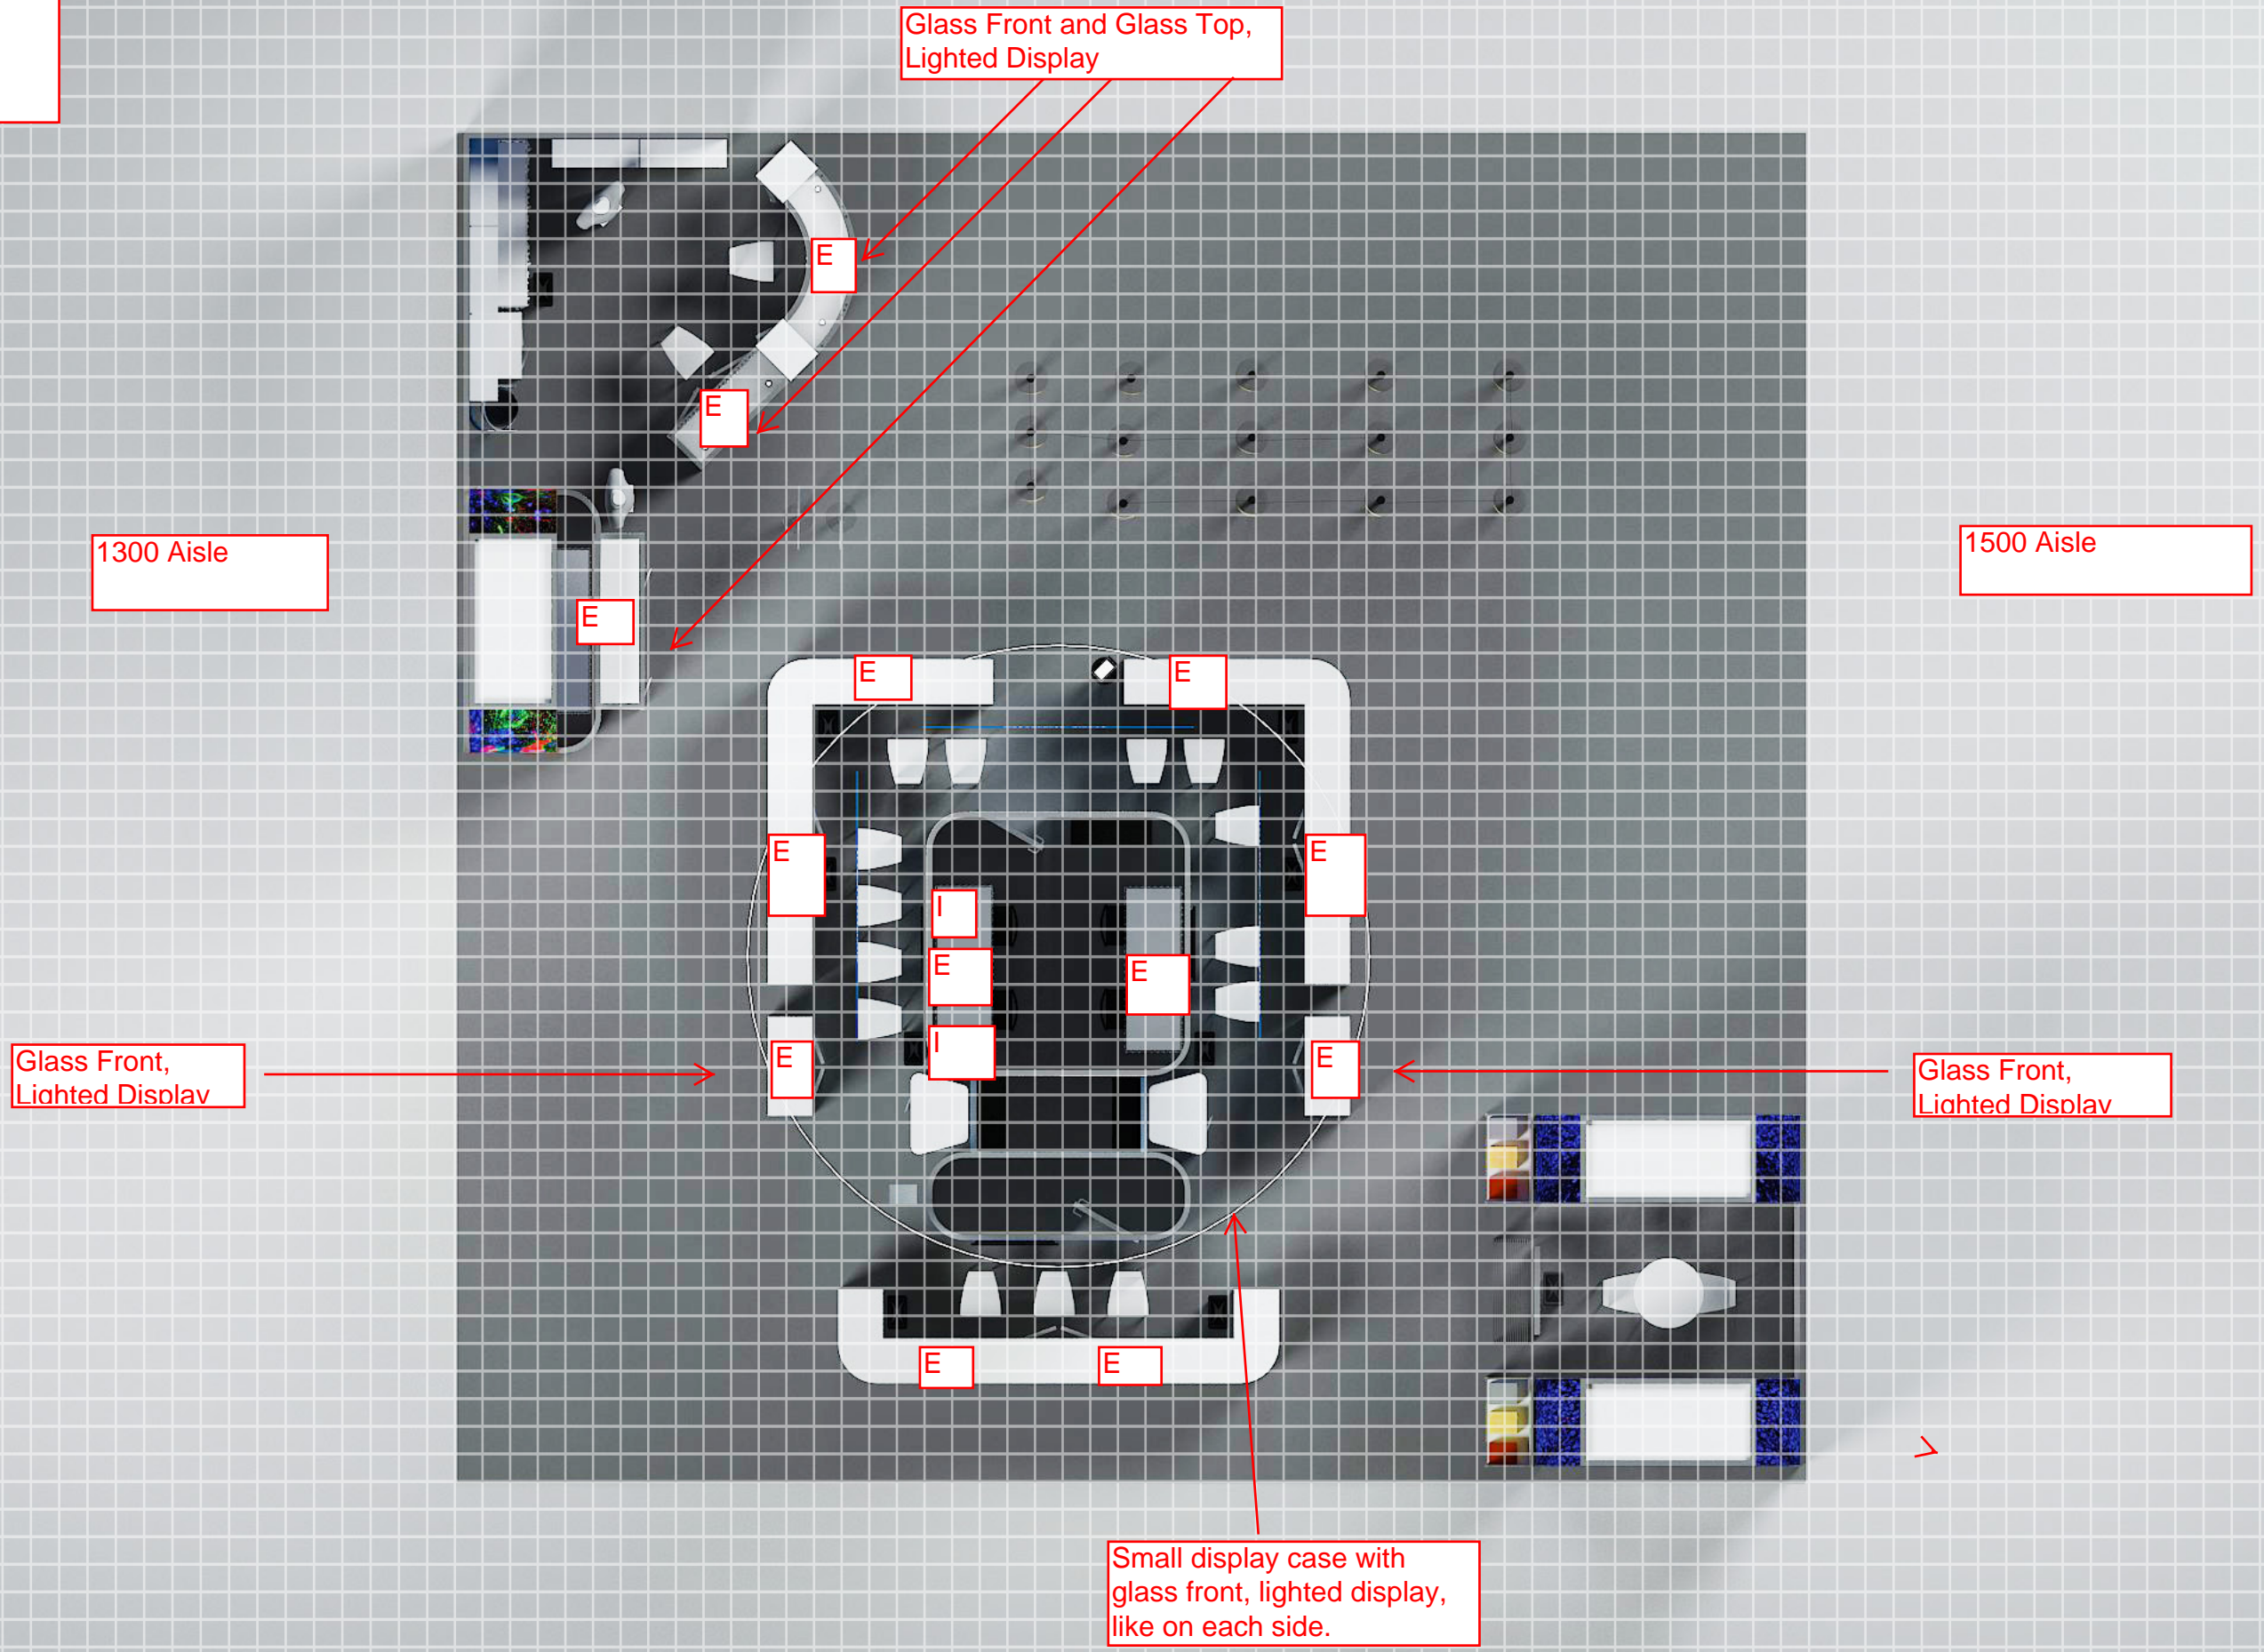

1300 Aisle

1500 Aisle

Glass Front,  
Lighted Display

Glass Front,  
Lighted Display

Small display case with  
glass front, lighted display,  
like on each side.

### Saturday Night Poster Sessions

Society for Neuroscience  
November 11-15 (Meeting) November 12-15 (Exhibits)  
EXHIBIT HALLS A,B,C  
WALTER E. WASHINGTON CONVENTION CENTER  
WASHINGTON, D.C.

EARLY CAREERS POSTER SESSIONS  
SATURDAY EVENING,  
NOVEMBER 11TH 6:30pm - 9:30pm

CAREER DEVELOPMENT TOPICS:  
A NETWORKING EVENT  
NOVEMBER 11TH 7:30pm - 9:30pm



POSTERBOARDS  
SS - 4x6 ..... 120  
DS - 4x6 ..... 610  
1,340 POSTER BOARD FACES

\*This floor plan is subject to fire marshal approval.

- Current As Of: 10-01-2023
- Job No.: 2311006
- Drawn By: sa
- Scale: Fit To Page

**THE EXPO GROUP**  
theexpogroup.com | 972.580.9000


**Disclaimer**  
Every effort has been made to ensure the accuracy of all information contained on this floor plan. However no warranties, either expressed or implied are made with respect to this floor plan. If the location of building columns, utilities or other architectural components of the facility is a consideration in the construction or usage of an exhibit, it is the sole responsibility of the exhibitor to physically inspect the facility to verify all dimensions and locations.

~~10/2/23~~

Updated  
11/2/23


B19

Exhibit Hall B  
50x50 area

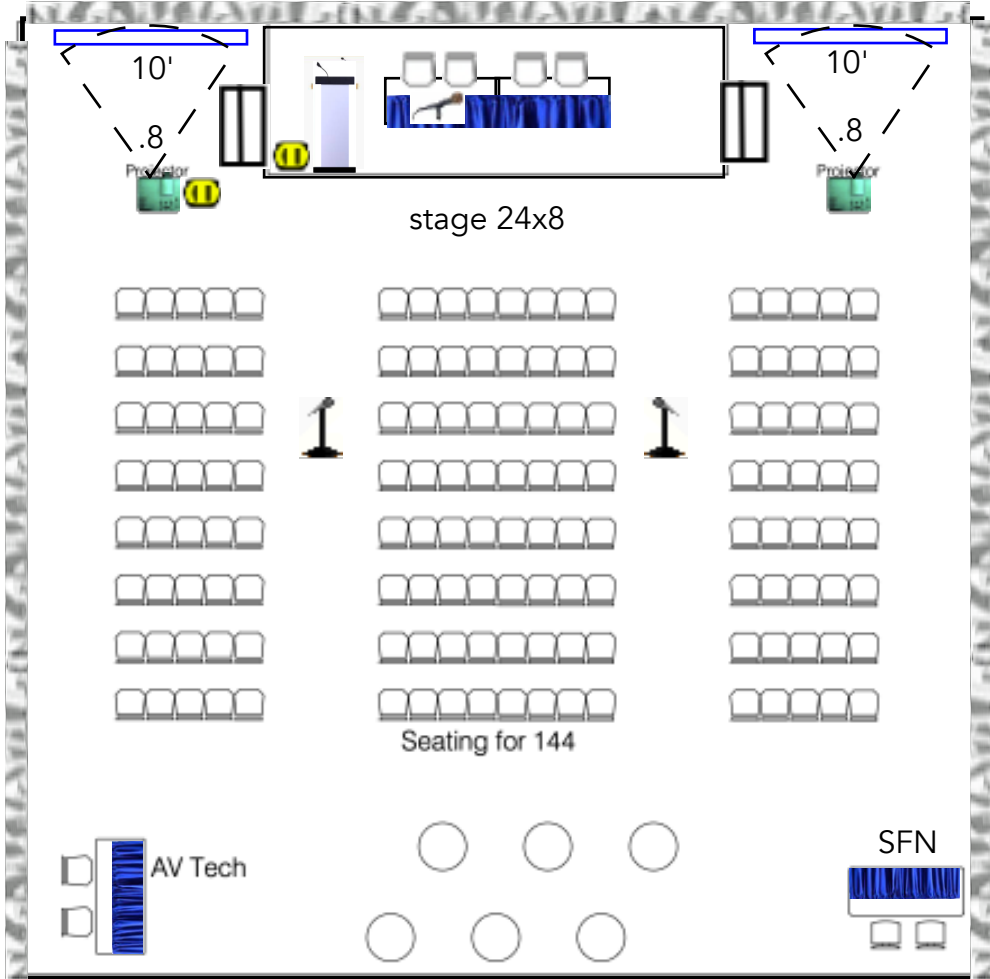

# Product Theater

Product Theater

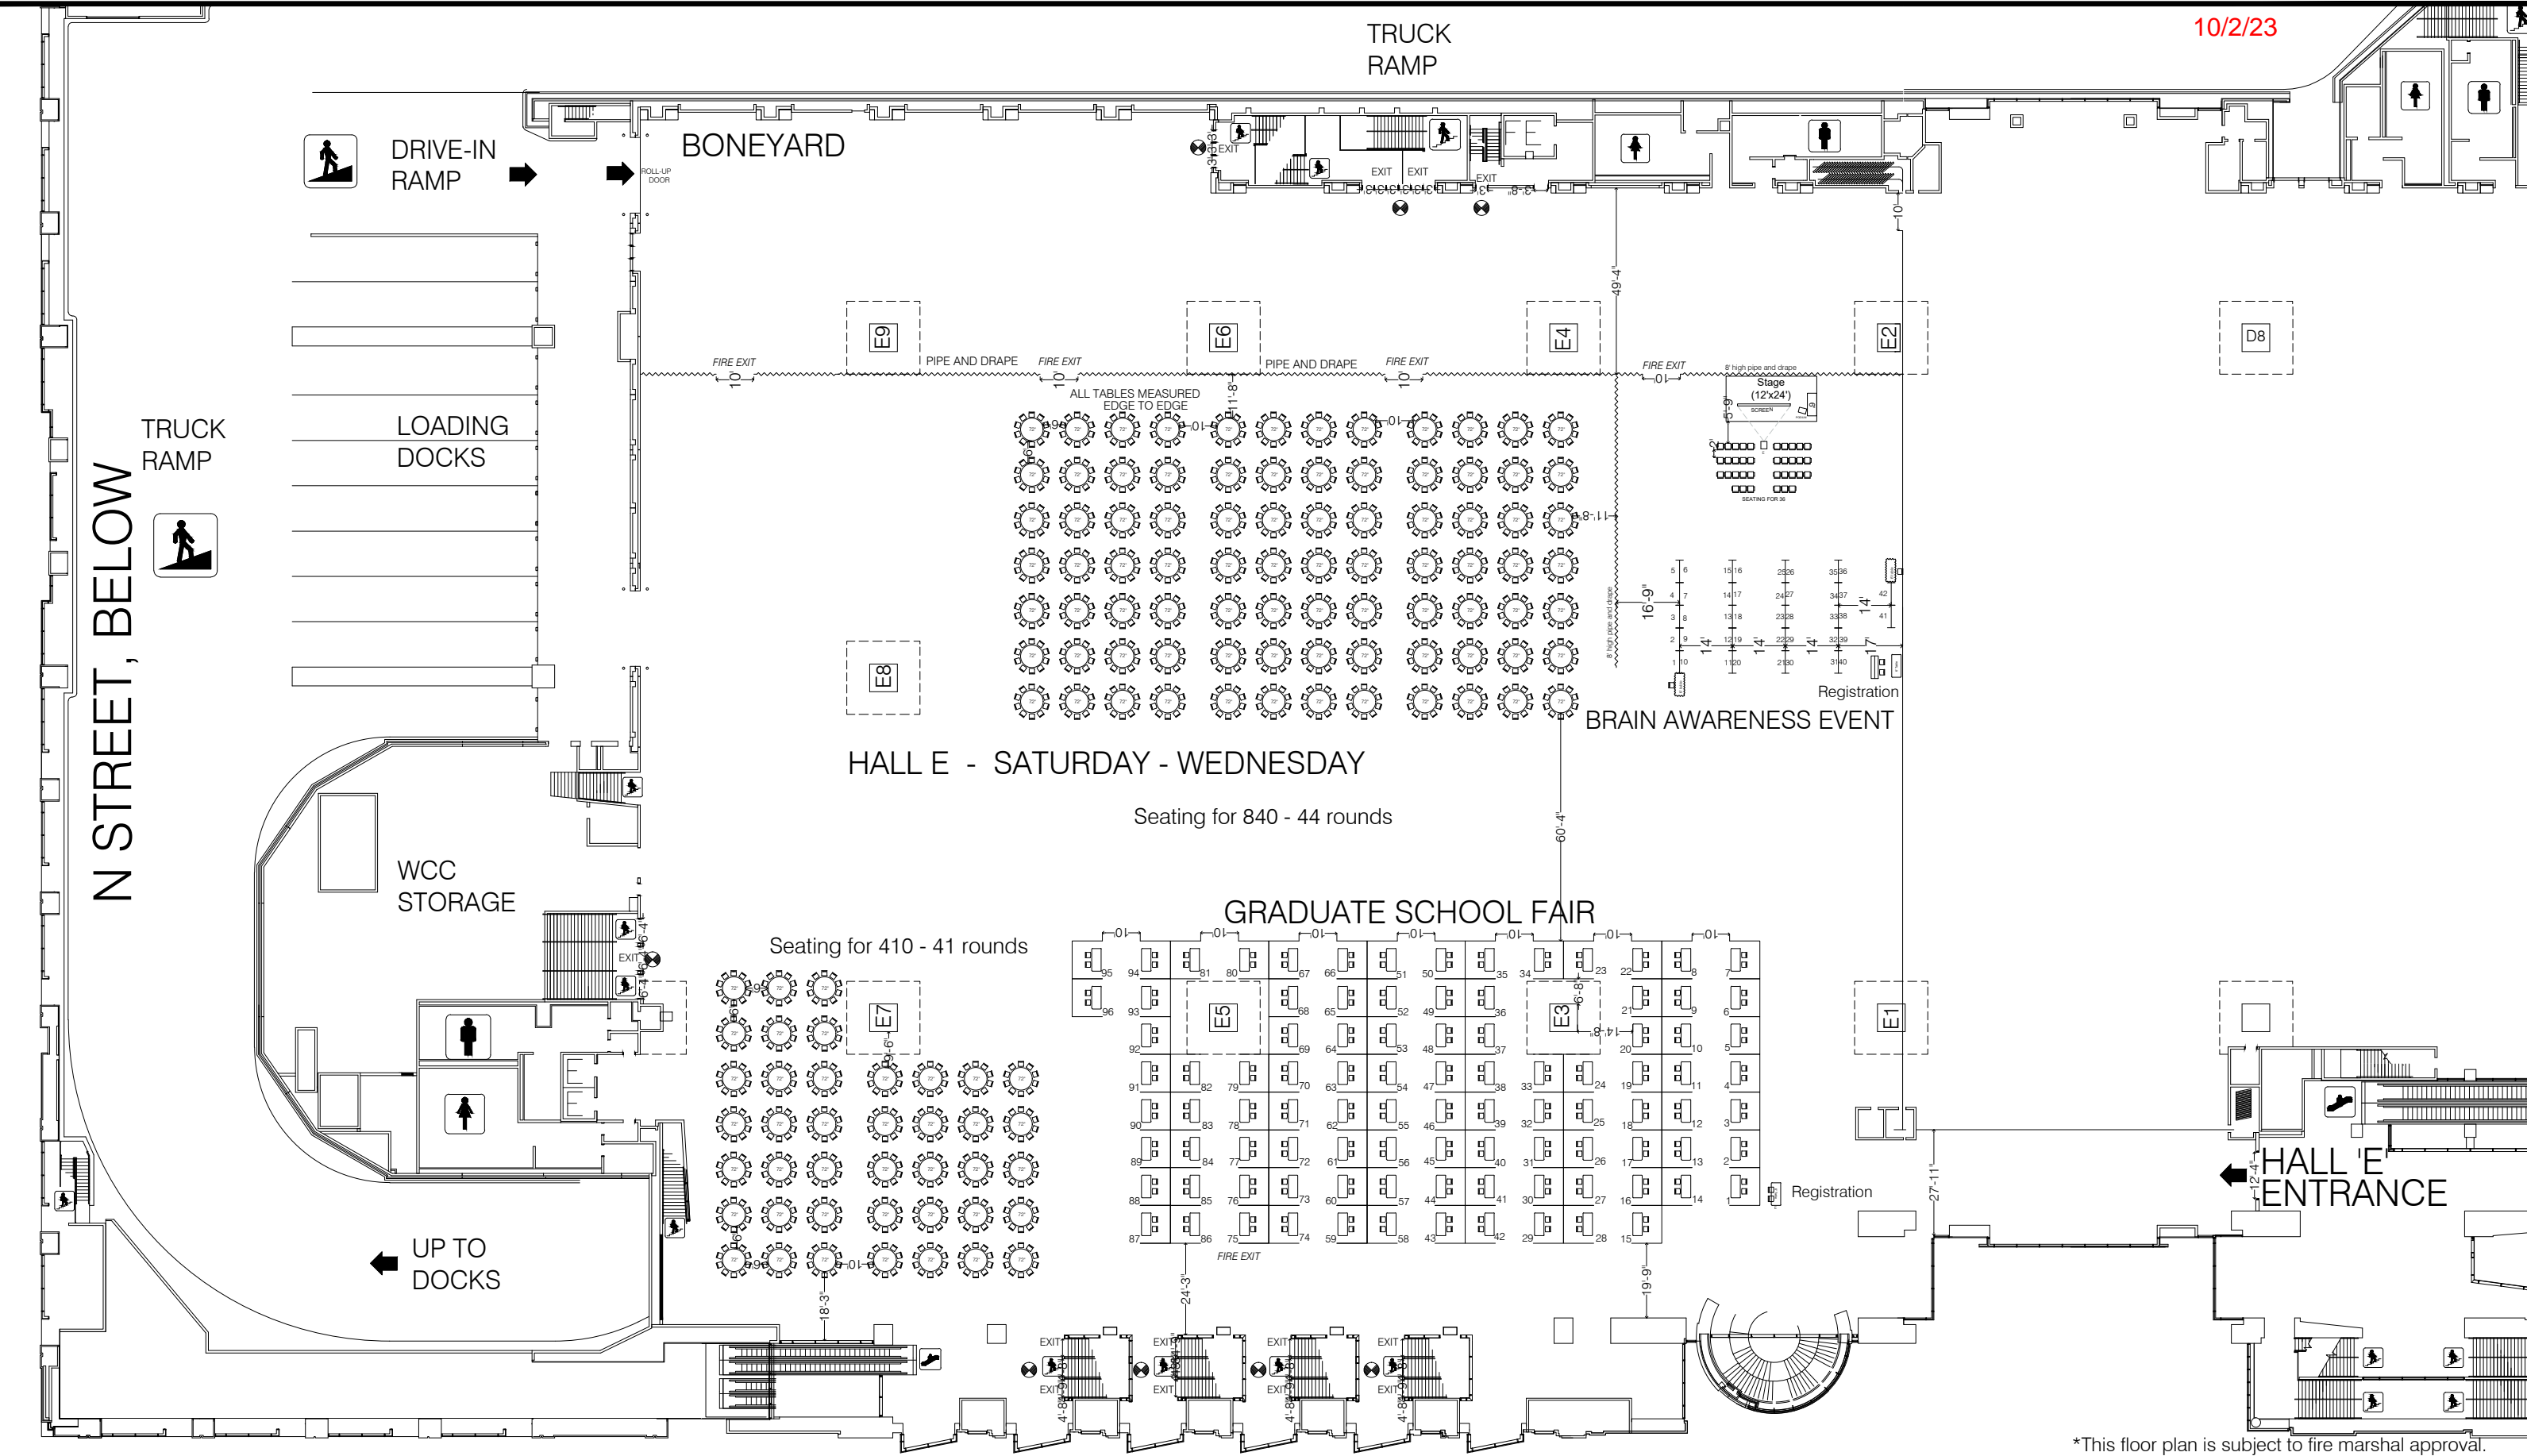

\*This floor plan is subject to fire marshal approval.



- Current As Of: 10-02-2023
- Job No.: 2311006
- Drawn By: SA
- Scale: Fit To Page

NEUROSCIENCE  
 NOVEMBER 12 - 15, 2023  
**HALL E**  
 WALTER E. WASHINGTON CONVENTION CENTER  
 WASHINGTON, D.C.

**THE EXPO GROUP**  
 theexpogroup.com | 972.580.9000

**Disclaimer**  
 Every effort has been made to ensure the accuracy of all information contained on this floor plan. However no warranties, either expressed or implied are made with respect to this floor plan. If the location of building columns, utilities or other architectural components of the facility is a consideration in the construction or usage of an exhibit, it is the sole responsibility of the exhibitor to physically inspect the facility to verify all dimensions and locations.

# GRADUATE SCHOOL FAIR

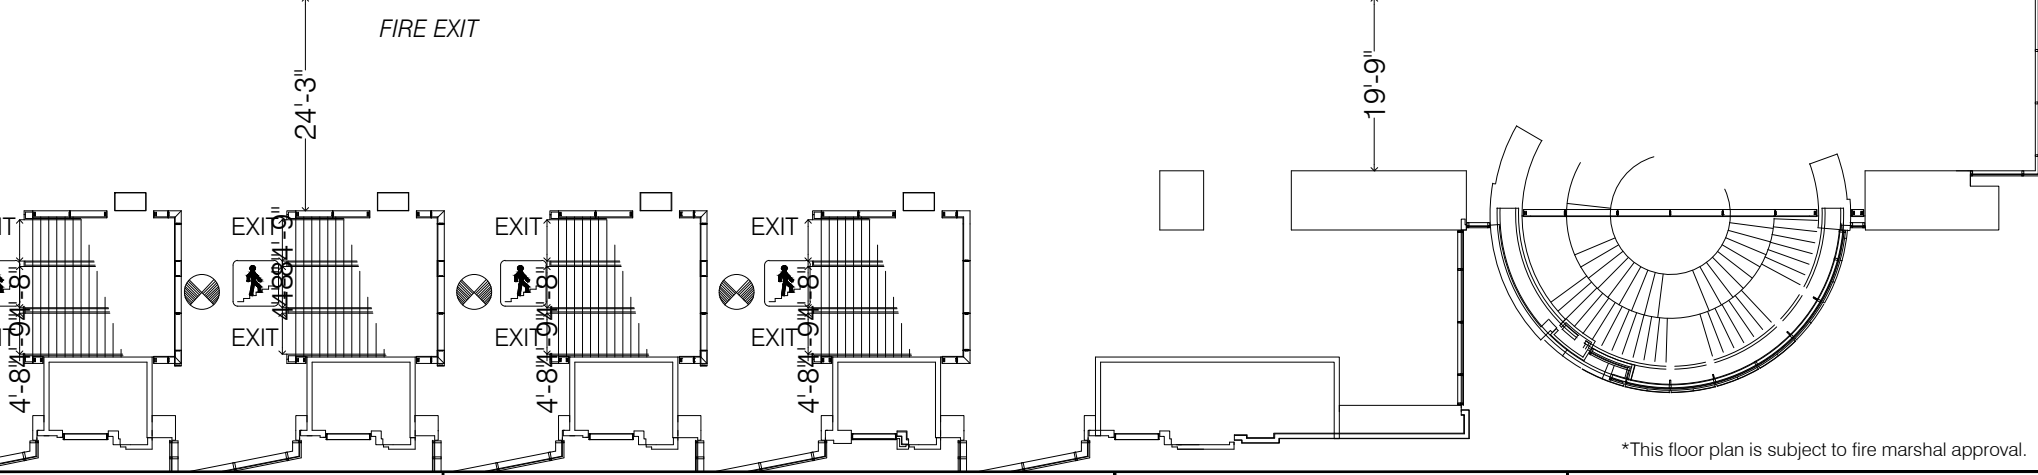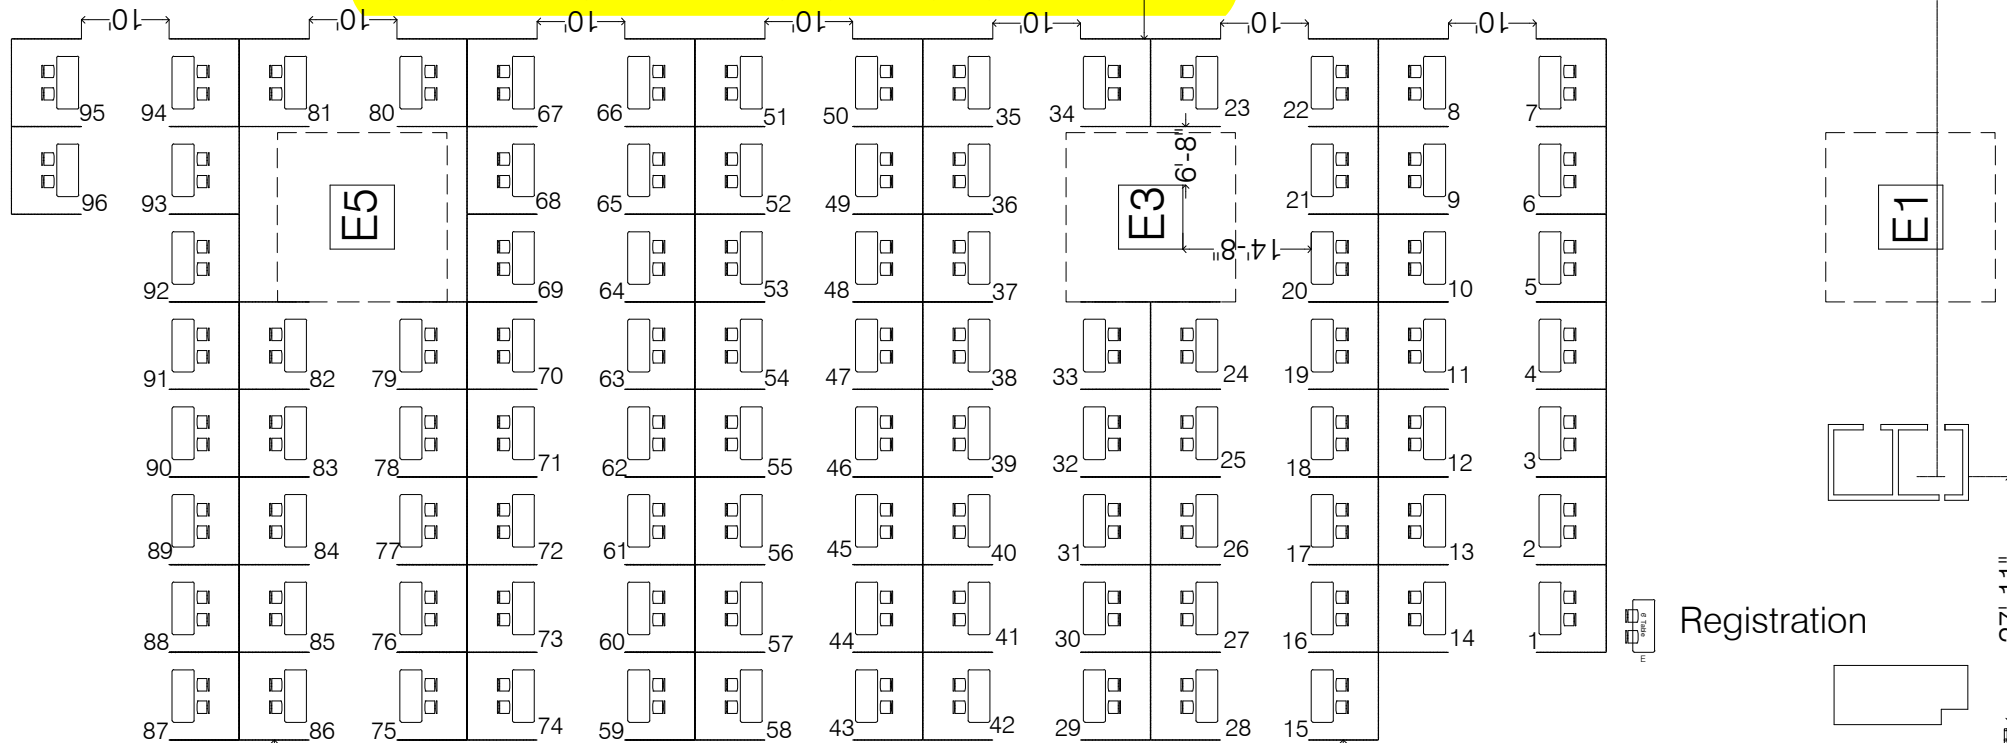

\*This floor plan is subject to fire marshal approval.

■ Current As Of: 10-02-2023  
 ■ Job No.: 2311006  
 ■ Drawn By: SA  
 ■ Scale: Fit To Page

NEUROSCIENCE  
 NOVEMBER 12 - 15, 2023  
 HALL E  
 WALTER E. WASHINGTON CONVENTION CENTER  
 WASHINGTON, D.C.

**THE EXPO GROUP**  
 theexpogroup.com | 972.580.9000





**Disclaimer**  
 Every effort has been made to ensure the accuracy of all information contained on this floor plan. However no warranties, either expressed or implied are made with respect to this floor plan. If the location of building columns, utilities or other architectural components of the facility is a consideration in the construction or usage of an exhibit, it is the sole responsibility of the exhibitor to physically inspect the facility to verify all dimensions and locations.

E4

E2

10/2/23

FIRE EXIT

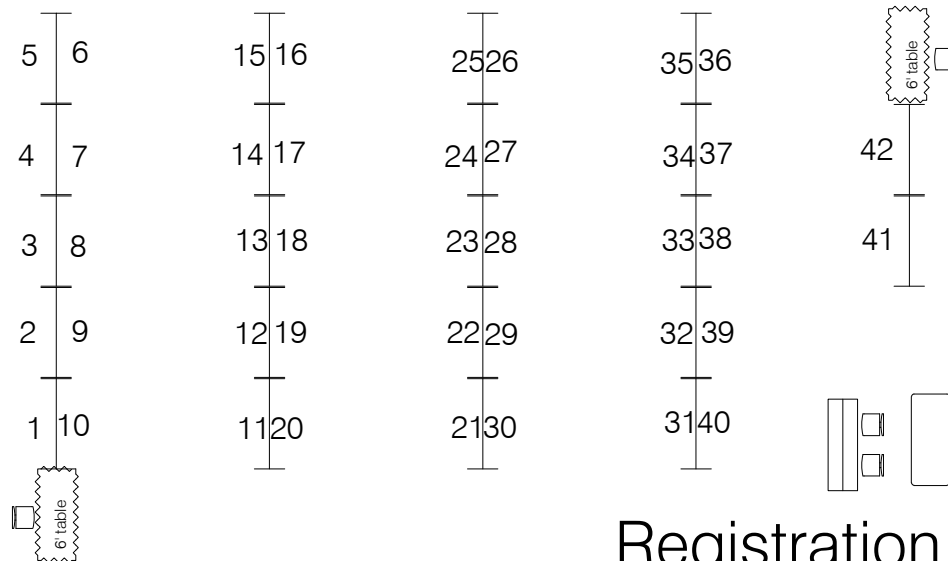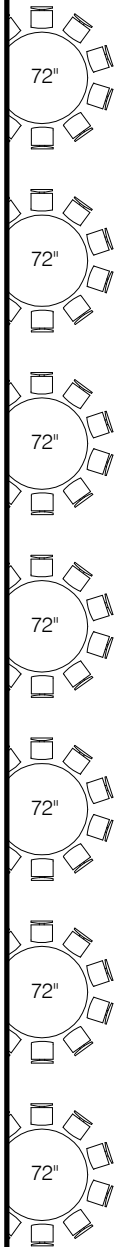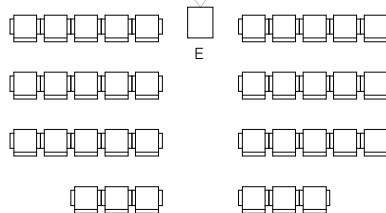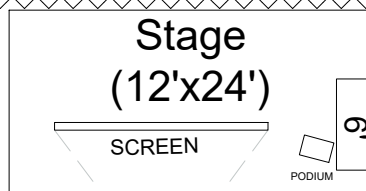

Registration

# BRAIN AWARENESS EVENT

\*This floor plan is subject to fire marshal approval.

- Current As Of: 09-18-2023
- Job No.: 2311006
- Drawn By: SA
- Scale: Fit To Page

NEUROSCIENCE  
NOVEMBER 12 - 15, 2023  
HALL E  
WALTER E. WASHINGTON CONVENTION CENTER  
WASHINGTON, D.C.

**THE EXPO GROUP**  
theexpogroup.com | 972.580.9000

**Disclaimer**  
Every effort has been made to ensure the accuracy of all information contained on this floor plan. However no warranties, either expressed or implied are made with respect to the floor plan. If the location of building columns, utilities or other architectural components of the facility is a consideration in the construction or usage of an exhibit, it is the sole responsibility of the exhibitor to physically inspect the facility to verify all dimensions and locations.



